
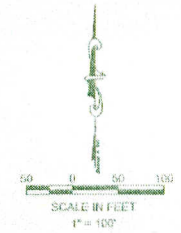


EXHIBIT C

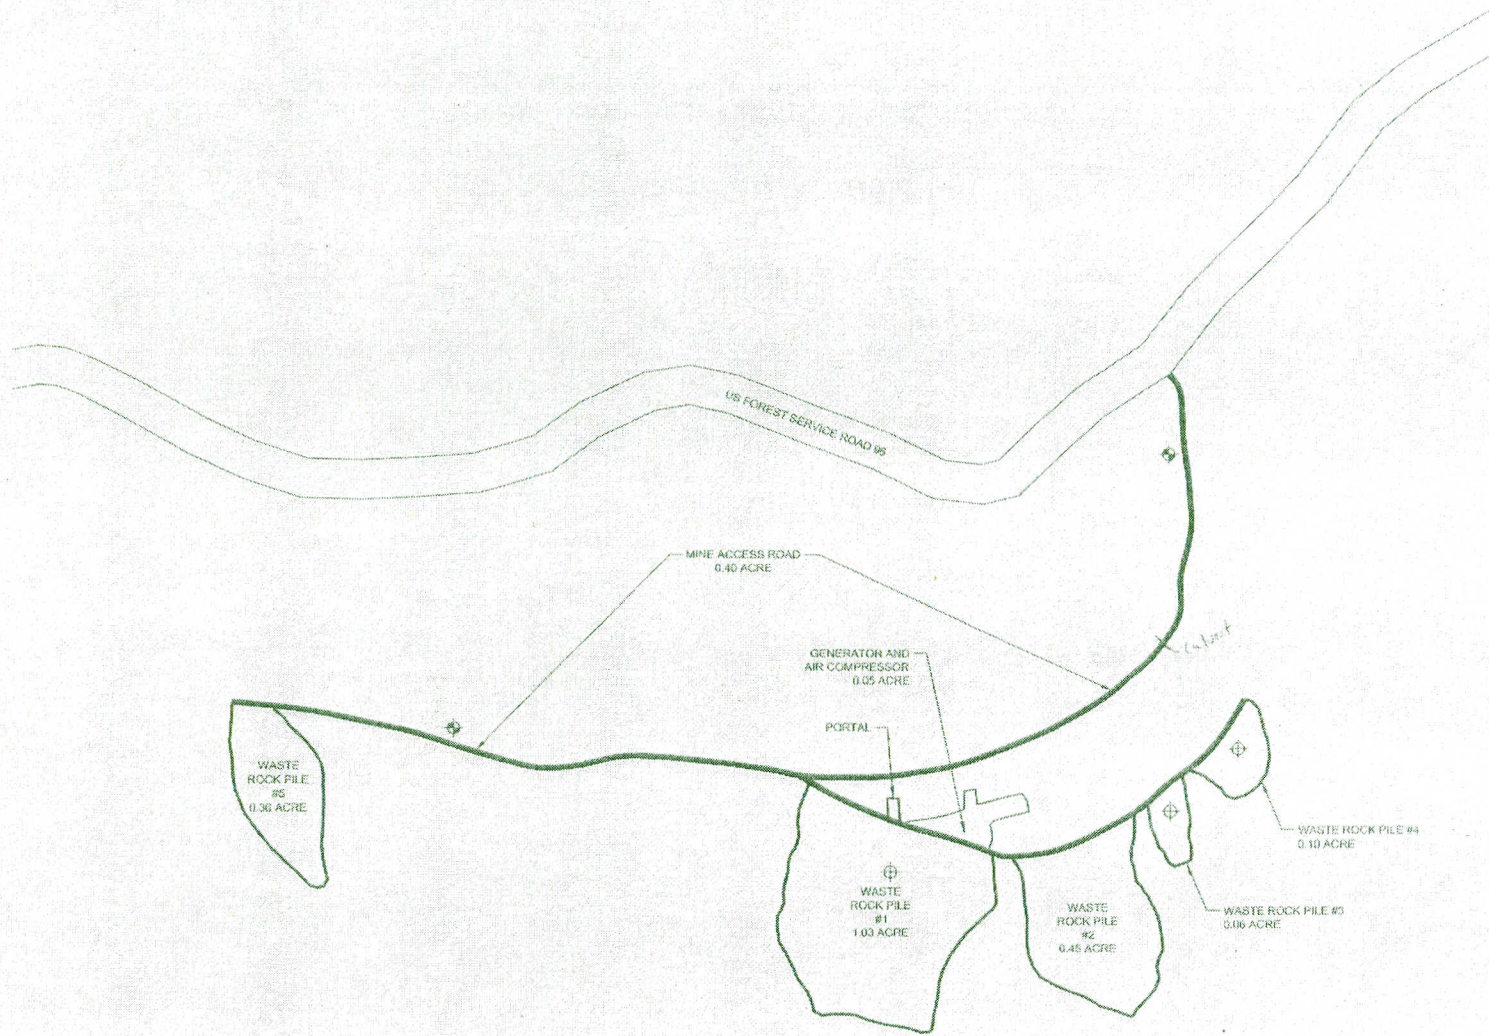

LEGEND
 ◆ APPROXIMATE PROPOSED BACKGROUND SAMPLE LOCATION
 ◆ APPROXIMATE PROPOSED SAMPLE LOCATION

1 OF 1

HK HOLDRECE & KULL
 CONSULTING ENGINEERS • GEOLOGISTS
 792 SEARLS AVENUE
 NEVADA CITY, CA 95959
 (530) 478-1305 FAX 478-1019

SITE PLAN FOR
BIG SEAM & RED INK MINING CLAIM
 FORESTHILL, CALIFORNIA

NO.	REVISIONS	DATE	DESIGNED BY: TJH
			DRAWN BY: DFD
			DATE: AUGUST 2006
			DRAWING NAME: 2890-01-SITE
			PROJECT NO.: 2890-01