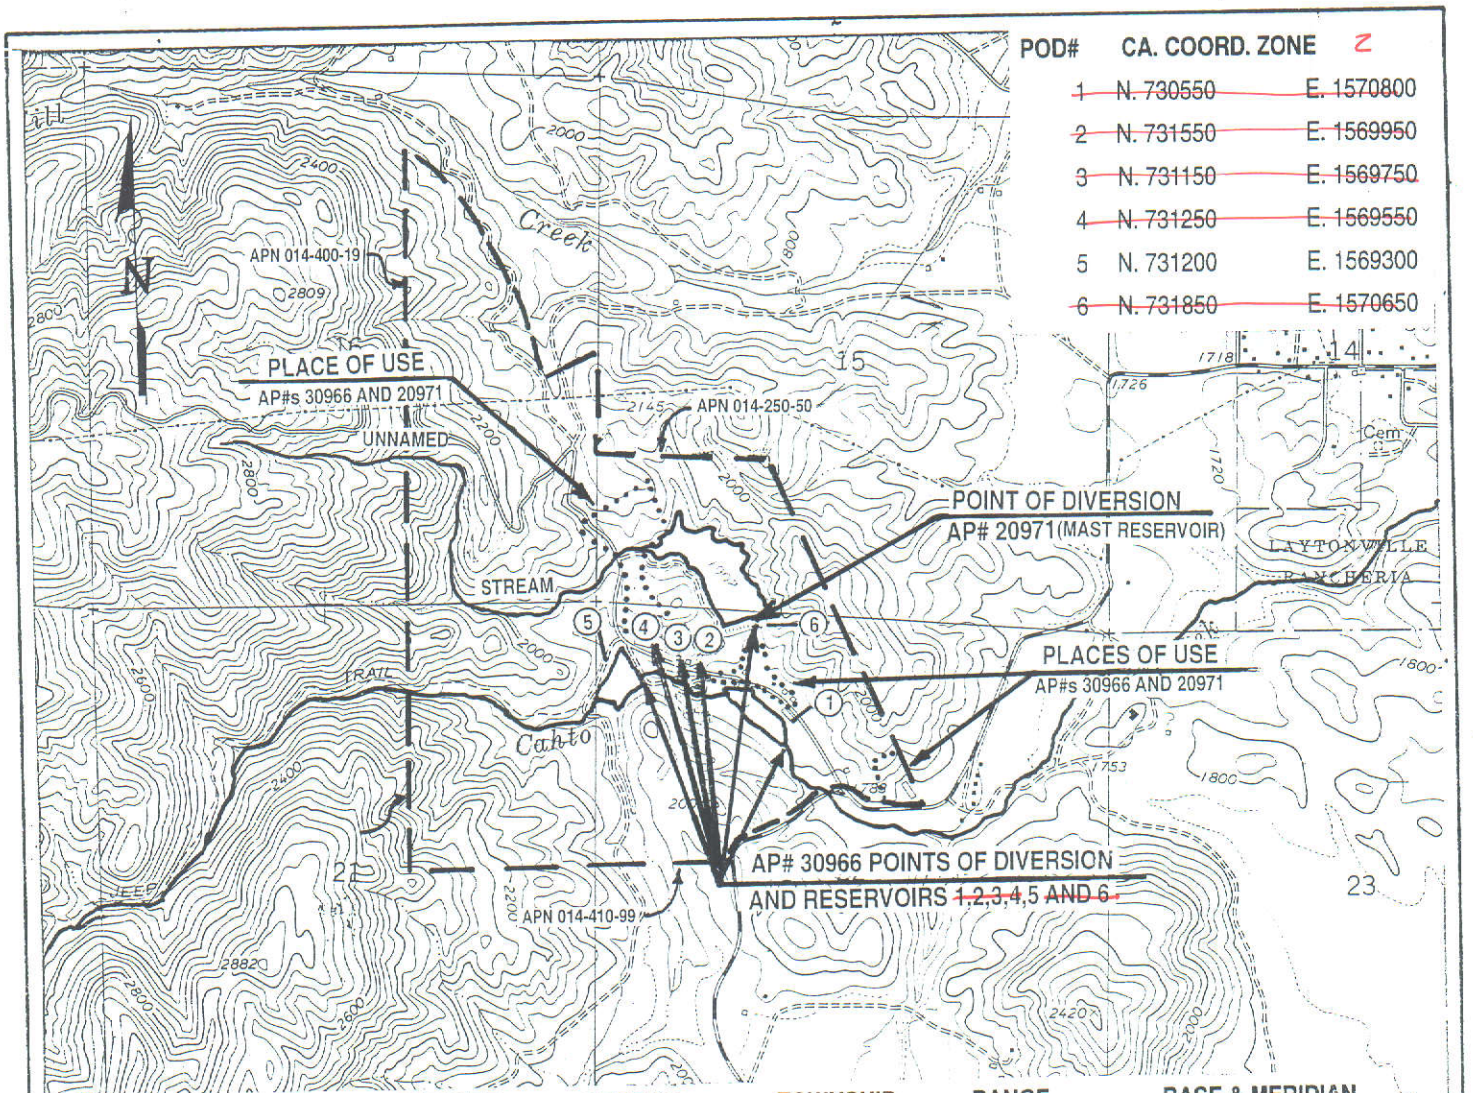

POD#	QUARTER	QUARTER	SECTION	TOWNSHIP	RANGE	BASE & MERIDIAN
1	NE	NW	22	21N	15W	MDB&M
2	NW	NW	22	21N	15W	MDB&M
3	NW	NW	22	21N	15W	MDB&M
4	NW	NW	22	21N	15W	MDB&M
5	NW	NW	22	21N	15W	MDB&M
~~6~~	~~NE~~	~~NW~~	~~22~~	~~21N~~	~~15W~~	~~MDB&M~~

~~1-6~~ OFF STREAM STORAGE

- POD

APPLICANT A30966 AND 20971 OF HOLQUIN

PERMIT NO. 16835

APPLICATION NO. 30966 & 20971 (LICENZE 9842)

SOURCE P.O.D.'s #1-6CAHTO CREEK TRIBUTARY TEN MILE CREEK

POINTS OF DIVERSION (SEE ABOVE)

WITHIN NE 1/4 NW 1/4 OF PROJECTED

SECTION 22, T21N, R15W, MDB&M

SEE QUESTION 7a OF APPLICATION FOR PLACE OF USE BREAKDOWN

COUNTY OF MENDOCINO

CAHTO PEAK — U.S.G.S.QUAD | 1970 — DATE | 1:24,000 — SCALE

STATE OF CALIFORNIA
STATE WATER RESOURCES CONTROL BOARD
DIVISION OF WATER RIGHTS

LICENSE
~~11215~~

REVISED

DATE:	DRAWN:	CHECKED:
March 20, 2001	D.Y.	

REVISED 8/7/05 2/23/06 MPL FAX