3

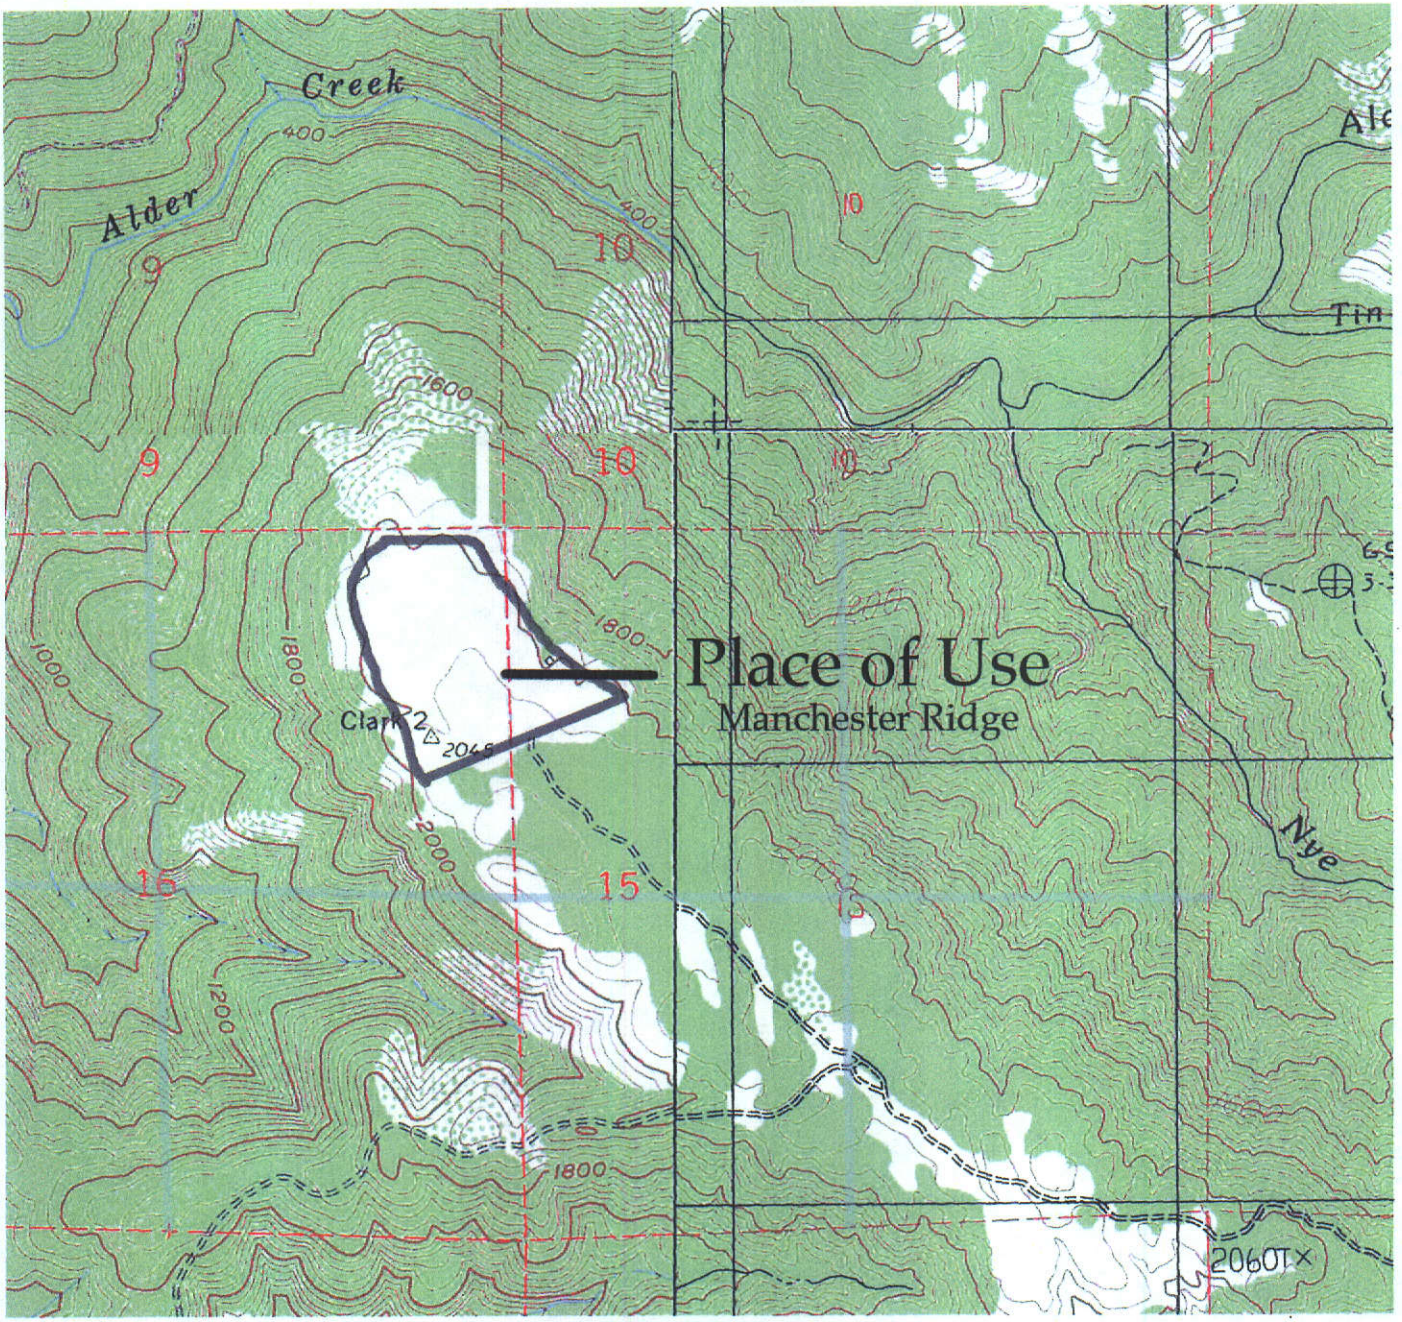

Creek
Alder
400
9
10
1600
1800
1000
Place of Use
Manchester Ridge
Clark 2
2048
2000
16
15
1200
Nye
Tin
2060T

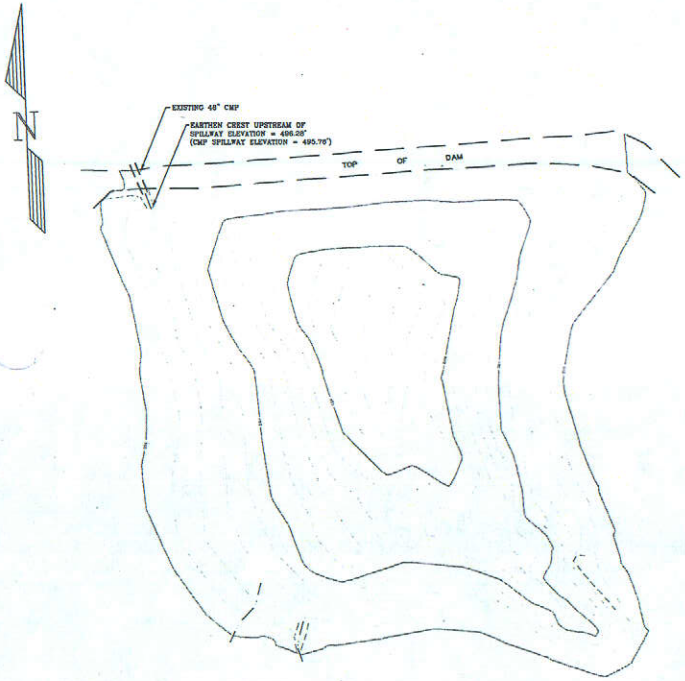

PLAN
1" = 40'

VICINITY MAP
1" = 3000'

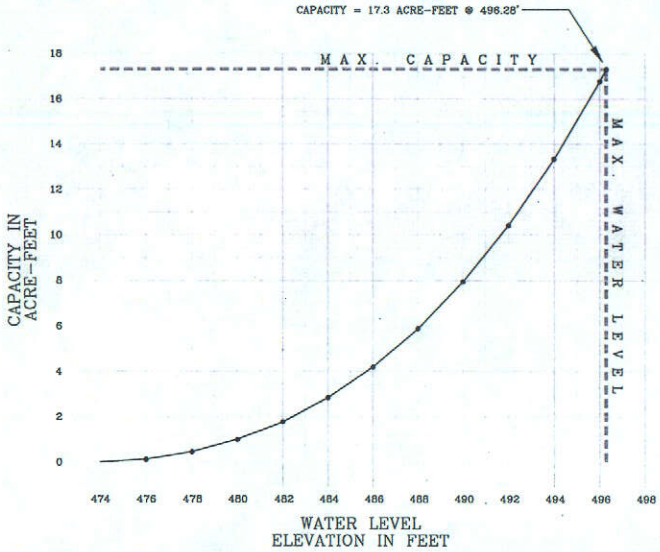

CAPACITY CURVE

NOTE:

AS-BUILT SURVEY BY MICHAEL W. BROOKS & ASSOCIATES, INC., MAY, 2009.

REGISTERED PROFESSIONAL ENGINEER
No. C 051461
Civil
STATE OF CALIFORNIA

SHEET 1

MANCHESTER RIDGE, LLC
MANCHESTER RIDGE VINEYARD

WATER STORAGE RESERVOIR
AS-BUILT AND CAPACITY CURVE

DWG. NUMBER: MRGMRC-R1
DATE: 05-08-09
SCALE: AS SHOWN

EDWARDS ENGINEERING
1606 MAIN STREET, SUITE 203
NAPA, CALIFORNIA 94559
(707) 258-6297
WWW.EDWARDSENGINEERING.NET